











**ELECTRICAL/TELECOMMUNICATIONS LEGEND**

-  WALL MOUNTED DUPLEX ELECTRICAL RECEPTACLE
-  WALL MOUNTED 4-PLEX (QUAD) ELECTRICAL RECEPTACLE
-  WALL MOUNTED DEDICATED ELECTRICAL CIRCUIT
-  WALL MOUNTED TELEPHONE OUTLET
-  WALL MOUNTED DATA/SIGNAL OUTLET
-  WALL MOUNTED COMBINATION DATA/VOICE OUTLET
-  FLOOR MOUNTED DUPLEX ELECTRICAL MONUMENT
-  FLOOR MOUNTED 4-PLEX ELECTRICAL MONUMENT
-  FLOOR MOUNTED SINGLE ELECTRICAL MONUMENT
-  FLOOR MOUNTED DATA/SIGNAL OUTLET
-  FLOOR MOUNTED TELEPHONE OUTLET
-  FLOOR MOUNTED COMBINATION DATA/VOICE OUTLET
-  POWER POLE
-  CABLE TV FEED



CIVIC CENTER  
FOR THE  
CITY OF HUNTINGTON BEACH, CA

LOWER LEVEL FLOOR PLAN  
2 OF 2  
ELECTRICAL/  
TELECOMMUNICATIONS

All drawings and written material appearing herein contain original and unpublished work of Mark IV and may not be used or disclosed without prior written consent of Mark IV.  
Portions of the information contained in this document are copyrighted by their respective companies and have been obtained from sources not connected with Mark IV.  
No guarantee, warranty, or representation, express or implied, is made as to the accuracy or thoroughness of such information or data.

07/17/01  
Revision Date:  
Mike Amdor  
Engineer  
Allen Maravilla  
Drawn By:  
No Scale  
Scale: